



345 Carlingview Drive  
Toronto, Ontario  
CANADA M9W 6N9  
Tel.: 416.734.3300  
Fax.: 416.231.1626  
Toll Free: 1.877.682.8772  
[www.tssa.org](http://www.tssa.org)

January 11, 2017

JOHN FRIEDRICHS  
CONTROLS CORPORATION OF AMERICA  
1501 HARPERS RD  
VIRGINIA BEACH VA 23454  
US

Service Request Type.: BPV-National AB  
Service Request No.: 1762976  
Your Reference No.: CONCOA SYSTEMS  
Registered to.: CONTROLS CORPORATION OF AMERICA

Dear JOHN FRIEDRICHS,

Please find enclosed the original response from AB, registered under the CRN No.:  
ON REG -0H17950.5, AB REG- 0H17255.2.

As all jurisdictional fees are handled by the Technical Standards and Safety Authority (TSSA), you do not pay any jurisdictions directly.

Should you have any questions or require further assistance, I will be happy to assist you.  
For general enquiries, please contact a Customer Service Advisor at 1.877.682.TSSA (8772) or e-mail [customerservices@tssa.org](mailto:customerservices@tssa.org). When contacting TSSA regarding this file, please refer to the Service Request number provided above.

Yours truly,

Joanna Karpinski

Tel: 416-734-3377  
Fax: 416-231-6183  
Email: [jkarpinski@tssa.org](mailto:jkarpinski@tssa.org)



the pressure equipment safety authority

9410 - 20 Ave N.W.

Edmonton, Alberta, Canada T6N 0A4

Tel: (780) 437-9100 / Fax: (780) 437-7787

November 25, 2016

**Attention:** Tanya Francis  
TECHNICAL STANDARDS & SAFETY AUTHORITY  
345 CARLINGVIEW DRIVE  
TORONTO, ON M9W 6N9

**Email:** tfrancis@tssa.org

The design submission, tracking number 2016-02810, originally received on May 13, 2016 was surveyed and accepted for registration as follows:

**CRN :** 0H17255.2 **Accepted on:** November 25, 2016

**Reg Type:** New Design **Expiry Date:** November 25, 2026

**Drawing No. :** 885 0038, ETC. Rev 0 As Noted

**Fitting type:** REGULATOR ASSEMBLIES

Design registered in the name of : CONTROLS CORPORATION OF AMERICA

**The registration is conditional on your compliance with the following notes:**

- This registration also includes drawings 885 0039 Rev 0, 885 0040 Rev 0, and 885 0041 Rev 0.
- The indication of CRN 0H05215.52 on drawing 885 0038 is understood to be a typographical error, intended to indicate CRN 0H05216.52.
- Parts used shall be those listed on the Bill of Materials of each drawing and are understood to be registered under the listed CRN, which is understood to be valid in Alberta and unexpired, and suited to the design service conditions. It is not permissible to substitute equivalent parts not manufactured within the scope of the listed CRNs. I have struck out the corresponding note on each drawing permitting identical part substitutions.
- This equipment shall not be pneumatically tested in Alberta.

As indicated on AB-41 Statutory Declaration form and submitted documentation, the code of construction is ASME B31.3.

*This registration is valid only for fittings fabricated at the location(s) covered by the QC certificate attached to the accepted AB-41 Statutory Declaration form. This registration is valid only until the indicated expiry date and only if the Manufacturer maintains a valid quality management system approved by an acceptable third-party agency until that date. Should the approval of the quality management system lapse before the expiry date indicated above, this registration shall become void.*

An invoice covering survey and registration fees will be forwarded from our Revenue Accounts.

Enclosed are stamped prints for your reference.

Sincerely,

BRANDON, GREG



the pressure equipment safety authority

STATUTORY DECLARATION  
Registration of Fittings

In this space, show facsimile of manufacturer's logo or trademark as it will appear on the fitting.

I, John Friedrichs,

Supervisor of Design Engineering

(company title, e.g. vice president, plant manager, chief engineer) (must be in a position of authority)

of Controls Corporation of America

(name of manufacturer)

located at 1501 Harpers Road, Virginia Beach, VA 23454

(plant address)

do solemnly declare that the fittings listed hereunder, which are subject to the Safety Codes Act (check one)

comply with the requirements of \_\_\_\_\_ which specifies the dimensions, (title of recognized North American Standard)

materials of construction, pressure/temperature ratings and identification marking of the fittings, or

are not covered by the provisions of a recognized North American standard and are therefore manufactured to comply with 4x max pressure burst test H as supported by the attached data which identifies the dimensions, materials of construction, pressure/temperature ratings and the basis for such ratings, and the marking of the fittings for identification.

I further declare that the manufacture of these fittings is controlled by a quality control program which has been verified by the following authority, Intertek Services Corporation as being suitable for the manufacture of these fittings to the stated standard. The fittings covered by this declaration, for which I seek registration, are ISO 9001

In support of this application, the following information, calculations and/or test data are attached:

Drawings and burst test data attached.

DECLARED before me at Virginia Beach in the STATE of Virginia

this 2<sup>ND</sup> day of November, 2015

(Month) (Year)

(print) Michael Irving

(sign) [Signature]

[Signature]

(Signature of Applicant)

(A Commissioner for Oaths) #7015528 EXP 31 MAY 2018

For Office Use Only

To the best of my knowledge and belief, the application meets the requirements of the Safety Codes Act and CSA Standard B51, Clause 4.2, and is accepted for registration in Category H as noted


Registration Number: OH17255 2

Date Registered: NOV 25 2016

(For the Administrator/Chief Inspector of Alberta)

Expiry Date: NOV 25 2026

THIS DOCUMENT CONTAINS CONFIDENTIAL OR PROPRIETARY INFORMATION OF CONTROLS CORP. OF AMERICA. NEITHER THE DOCUMENT NOR THE INFORMATION THEREIN IS TO BE REPRODUCED, DISTRIBUTED, USED, OR DISCLOSED, EITHER IN WHOLE OR IN PART EXCEPT AS SPECIFICALLY AUTHORIZED, AND MUST BE RETURNED PROMPTLY WITH FINISHED MATERIAL, QUOTATION OR UPON REQUEST.

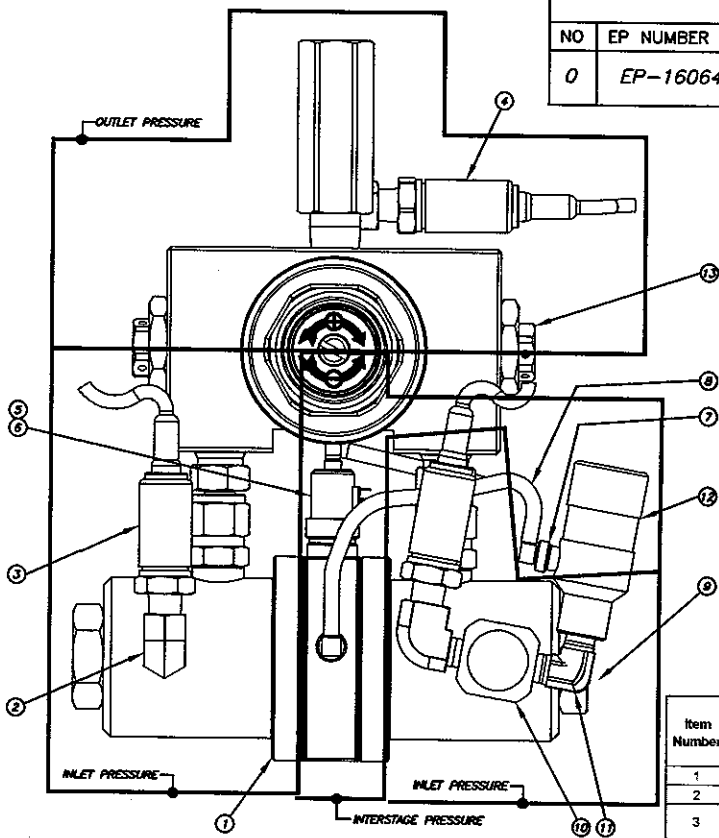

<b>Inlet Section:</b> 3000 psi @ -40°F to 140°F (3300 pneumatic leak test) Using components 1, 2, 3, 9, 10, 11, 12, 13
<b>Interstage Section:</b> 90 psi @ -40°F to 140°F (99 pneumatic leak test) Using components 5, 6, 7, 8, 12
<b>Outlet Section:</b> 200 psi @ -40°F to 140°F (220 pneumatic leak test) Using components 4, 9, 13

REVISIONS					
NO	EP NUMBER	DESCRIPTION	INITIALS	DATE	APPROVED
0	EP-16064	ISSUED FOR ABSA CRN SUBMISSION	JF	11/25/2016	_____

PT NO  
885 0038

**ABSA**  
SAFETY CODES ACT - PROVINCE OF ALBERTA  
REGISTRATION OF FITTINGS

REGISTRATION NO. **OH17255.2**

DWG. NO. & CAT. NO. ~~885 0038~~ **885 0038 Rev 0, etc.**

TYPE OF FITTINGS: **Regulator Assemblies**

Accepted As NOTED: *[Signature]*

NOV 25 2016  
Date

INITIALS: *[Signature]*

GREGORY E. BRANDON P.Eng.  
DESIGN SURVEY ENGINEER

See Acceptance Letter for the comments and/or conditions of registration.

Item Number	Part Number	Description	Material	Existing CRN Component Pressure Rating	Pressure In CONCOA Product	Existing CRN
1	8050000	switch	BRASS, ASTM B-16, 36000	3000 psig	Inlet	CONCOA CRN QA17946.5
2	8306616	elbow	BRASS, ASTM B-16, 36000	3500 psig	Inlet	CONCOA CRN QA17946.5
3	8309150-11	transducer	STAINLESS STEEL, 17-7	9790 psig	Inlet	OF17333.5; OF6726.4; CSA-OF 1494.6; OF15348.2
4	8309150-12	transducer	STAINLESS STEEL, 17-7	9790 psig	Outlet	OF17333.5; OF6726.4; CSA-OF 1494.6; OF15348.2
5	8309140-4	solenoid valve	BRASS, ASTM B-16 OR C37700	163 psig	Interstage	QA17946.5
6	8309140-11	solenoid valve	BRASS, ASTM B-16 OR C37700	163 psig	Interstage	QA17946.5
7	8309712	elbow	BRASS, ASTM B-16, 36000	120 psig	Interstage	CONCOA CRN QA17946.5
8	90800036	tubing	POLYURETHANE	120 psig	Interstage	QA17946.5
9	8350019	extension	BRASS, ASTM B-16, 36000	3500 psig	Inlet	CONCOA CRN QA17946.5
10	8030507	tee	BRASS, ASTM B-16, 36000	4500 psig	Inlet	CONCOA CRN QA17946.5
11	8308440	elbow	BRASS, ASTM B-16, 36000	4000 psig	Inlet	SwageLok CRN QA12577.5C or HyLok CRN QA4093.2
12	80525XX	pilot reg	BRASS, ASTM B-16, 36000	3000 psig to 200 psig	Inlet / Interstage	CONCOA CRN OC17947.5
13	80500XX	line reg	BRASS, ASTM B-16, 36000	3000 psig to 200 psig	Inlet / Outlet	CONCOA CRN OC17947.5


*Scope includes other products utilizing identical designs for high pressure and low pressure control (to include temp ratings, pressure and all other functional aspects)*

SCALE: X	THIRD ANGLE PROJECTION	TOLERANCE UNLESS OTHERWISE SPEC'D DIMENSIONS ARE IN INCHES DIM. & TOL. PER ANSI Y14.5	DRAWN BY	ITEM	PART NO / SIZE	QTY	MATERIAL / DESCRIPTION
TITLE BLOCK REVISION: #7	REVISION DATE: 1/31/2003	FINISH: $\epsilon/$ XXX DECIMALS: $\pm .005$ XX DECIMALS: $\pm .010$ FRACTIONS: $\pm 1/64$ ANGLES: $\pm 2^\circ$ FILLET RADII: R 1/64 BREAK EDGES: .002-.010	DESIGN ENGINEERING	<b>CONCOA</b> CONTROLS CORPORATION OF AMERICA PRODUCT ENGINEERING DEPARTMENT VIRGINIA BEACH, VA 23454			PART NO. <b>885 0038</b>
CAD FILENAME: A.dwg	WHERE USED: ABSA File	MANUFACTURING ENG	ABSA Control Drawing 538/539/640/642				
		CAGE NUMBER: <b>0A389</b>	QUALITY ASSURANCE	ISSUING REFERENCE DOCUMENT #			SIZE: <b>A</b>
							<b>EP-16064</b>

THIS DOCUMENT CONTAINS CONFIDENTIAL OR PROPRIETARY INFORMATION OF CONTROLS CORP. OF AMERICA. NEITHER THE DOCUMENT NOR THE INFORMATION THEREIN IS TO BE REPRODUCED, DISTRIBUTED, USED, OR DISCLOSED EITHER IN WHOLE OR IN PART EXCEPT AS SPECIFICALLY AUTHORIZED, AND MUST BE RETURNED PROMPTLY WITH FINISHED MATERIAL, QUOTATION OR UPON REQUEST.

REVISIONS					
NO	EP NUMBER	DESCRIPTION	INITIALS	DATE	APPROVED
0	EP-16064	ISSUED FOR ABSA CRN SUBMISSION	JF	11/25/2016	_____

PT NO  
885 0039

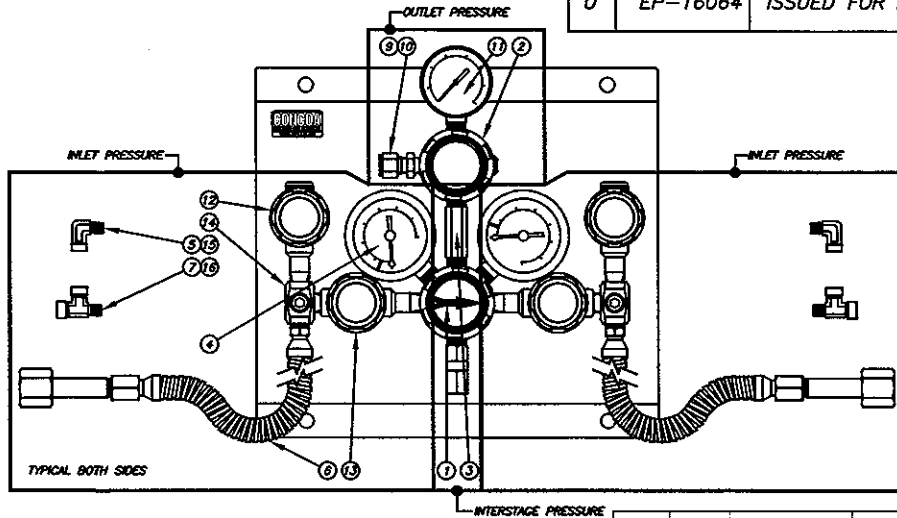

OH17255 2

NOV 25 2016


Inlet Section:
Option 1: 4500 psi @ -40°F to 140°F (4950 pneumatic leak test) Using components 1, 4a or 4b, 5, 7, and 14
Option 2: 3000 psi @ -40°F to 140°F (3300 pneumatic leak test) Using components 1, 4c, 12, 13, 14, 15, and 16
Interstage Section:
500 psi @ -40°F to 140°F (550 pneumatic leak test) Using components 1, 2, and 3
Outlet Section:
250 psi @ -40°F to 140°F (275 pneumatic leak test) Using components 2, 9, 10, and 11

Item Number	Part Number	Description	Material	Existing CRN Component Pressure Rating	Pressure in CONCOA Product	Existing CRN?
1	619 Series	Switch Regulator	BRASS, ASTM B-16, 36000	4500 psig to 500 psig	Inlet/Interstage	CH5216 SR1
2	491 Series	Line Regulator	BRASS, ASTM B-16, 36000	3000 psig to 500 psig	Interstage/Outlet	CH5216 SR1
3	8306335	pipe nipple	BRASS, ASTM B-16, 36000	4000 psig	Interstage	Swagelok CRN OA12577.5C or HyLok CRN OA4093.2 or SSP CRN QA9866.5
4(a)	8410674	pressure switch gauge	BRASS, ASTM B 16, 38500 STEM BRASS, ASTM B-103, 52109 TUBE	6000 psig	Inlet	OA17946.5
4(b)	5500309	gauge	BT: CU2N37 - SOCKET: BRASS	6000 psig	Inlet	WIKA CRN OF2026.2 or Ametek CRN OF8241.5
4(c)	5500308	gauge	BT: CU2N37 - SOCKET: BRASS	4000 psig	Inlet	WIKA CRN OF2026.2 or Ametek CRN OF8241.5
5	8306196	elbow	STAINLESS STEEL, ASTM A182 or A183 316	6600 psig	Inlet	Swagelok CRN OA12577.5C or HyLok CRN OA4093.2 or SSP CRN QA9866.5
6	5290000	pigtail			Inlet	Excluded from this listing
7	8305396	street tee	STAINLESS STEEL, ASTM A182 or A183 316	8600 psig	Inlet	Swagelok CRN OA12577.5C or HyLok CRN OA4093.2 or SSP CRN QA9866.5
9	5550220	tube fitting	STAINLESS STEEL, ASTM A276, 316L or A479, 316	8000 psig	Outlet	Swagelok CRN OA12577.5C or HyLok CRN OA4093.2 or SSP CRN QA9866.5
10	5500165	tube fitting	STAINLESS STEEL, ASTM A276, 316L or A479, 316	8000 psig	Outlet	Swagelok CRN OA12577.5C or HyLok CRN OA4093.2 or SSP CRN QA9866.5
11	5500305	gauge	BT: CU2N37 - SOCKET: BRASS	400 psig	Outlet	WIKA CRN OF2026.2 or Ametek CRN OF8241.5
12	5333029	diaphragm valve	BRASS, ASTM B 16, 36000	3000 psig	Inlet	CH5216 SR1
13	5333029	diaphragm valve	BRASS, ASTM B 16, 36000	3000 psig	Inlet	CH5216 SR1
14	8030507	micro tee	STAINLESS STEEL, ASTM A276, 316L	4500 psig	Inlet	OA17946.5
15	8306195	elbow	BRASS, ASTM B283, 37700	3300 psig	Inlet	Swagelok CRN OA12577.5C or HyLok CRN OA4093.2 or SSP CRN QA9866.5
16	8305395	street tee	BRASS, ASTM B283, 37700	3300 psig	Inlet	Swagelok CRN OA12577.5C or HyLok CRN OA4093.2 or SSP CRN QA9866.5

Scope includes other products utilizing identical designs for high pressure and low pressure service (to include lamp ratings, pressures and all other functional details)

SCALE: <b>X</b>	THIRD ANGLE PROJECTION 	TOLERANCE UNLESS OTHERWISE SPEC'D DIMENSIONS ARE IN INCHES DIM. & TOL. PER ANSI Y14.5	DRAWN BY	ITEM	PART NO / SIZE	QTY	MATERIAL / DESCRIPTION
TITLE BLOCK REVISION: #7	REVISION DATE: 1/31/2003	FINISH: XXX DECIMALS: ±.005 XX DECIMALS: ±.010 FRACTIONS: ±1/64 ANGLES: ±2° FILLET RADII: R 1/64 BREAK EDGES: .002-.010	DESIGN ENGINEERING	<b>CONCOA</b> CONTROLS CORPORATION OF AMERICA PRODUCT ENGINEERING DEPARTMENT VIRGINIA BEACH, VA 23454			PART NO. <b>885 0039</b>
CAD FILENAME: A.dwg	WHERE USED: ABSA File	CAGE NUMBER 0A389	MANUFACTURING ENG				<b>ABSA Control Drawing</b> <b>619</b>
			QUALITY ASSURANCE	TITLE			SIZE A

THIS DOCUMENT CONTAINS CONFIDENTIAL OR PROPRIETARY INFORMATION OF CONTROLS CORP. OF AMERICA. NEITHER THE DOCUMENT NOR THE INFORMATION THEREIN IS TO BE REPRODUCED, DISTRIBUTED, USED, OR DISCLOSED, EITHER IN WHOLE OR IN PART EXCEPT AS SPECIFICALLY AUTHORIZED, AND MUST BE RETURNED PROMPTLY WITH FINISHED MATERIAL, QUOTATION OR UPON REQUEST.

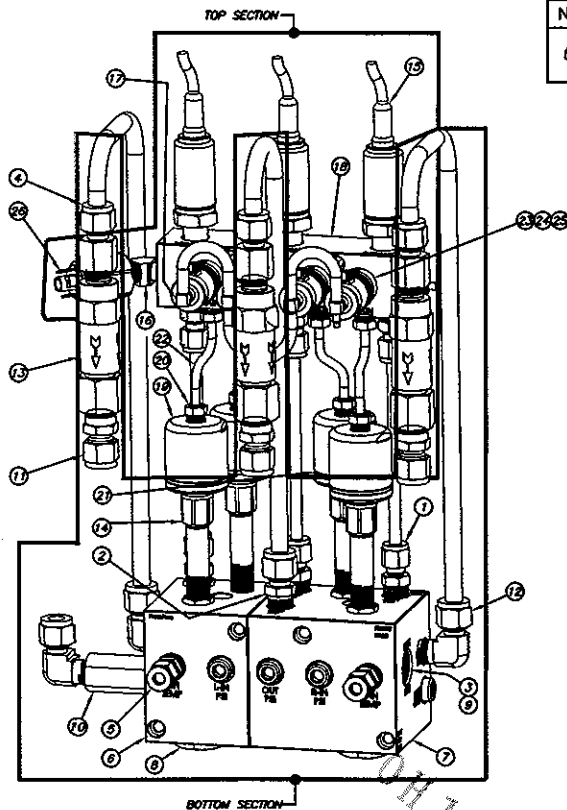

**Bottom Section:**  
50 psi @ -321°F to 100°F (55 pneumatic leak test)  
Using components 1-15

**Top Section:**  
110 psi @ -40°F to 140°F (121 pneumatic leak test)  
Using components 16-26

Scope includes other products utilizing identical designs for high pressure and low pressure controls (to include temp ratings, pressures and all other functional aspects)


REVISIONS						PT NO
NO	EP NUMBER	DESCRIPTION	INITIALS	DATE	APPROVED	
0	EP-16064	ISSUED FOR ABSA CRN SUBMISSION	JF	11/25/2016		885 0040

Item Number	Part Number	Description	Material	Existing CRN Component Pressure Rating	Pressure In CONCOA Product	Existing CRN?
1	5550220	tube fitting	STAINLESS STEEL, ASTM A276, 316L or A479, 316	8000 psig	Bottom Block	Swagelok CRN OA12577.5C or HyLok CRN OA4093.2 or SSP CRN OA9866.5
2	5560322	tube fitting	STAINLESS STEEL, ASTM A276, 316L or A479, 316	4000 psig	Bottom Block	Swagelok CRN OA12577.5C or HyLok CRN OA4093.2 or SSP CRN OA9866.5
3	8350390	bulkhead	BRASS, ASTM B-16, 36000	435 psig	Bottom Block	OA17946.5
4	8350642	tube fitting	STAINLESS STEEL, ASTM A276, 316L or A479, 316	4000 psig	Bottom Block	Swagelok CRN OA12577.5C or HyLok CRN OA4093.2 or SSP CRN OA9866.5
5	8350646	tube fitting	STAINLESS STEEL, ASTM A276, 316L or A479, 316	8000 psig	Bottom Block	Swagelok CRN OA12577.5C or HyLok CRN OA4093.2 or SSP CRN OA9866.5
6	8350653	left block	BRASS, ASTM B-16, 36000	435 psig	Bottom Block	OA17946.5
7	8350654	right block	BRASS, ASTM B-16, 36000	435 psig	Bottom Block	OA17946.5
8	8350662	rear plug	BRASS, ASTM B-16, 36000	435 psig	Bottom Block	OA17946.5
9	8350666	bulkhead	BRASS, ASTM B-16, 36000	435 psig	Bottom Block	OA17946.5
10	8350667	fitting	BRASS, ASTM B-16, 36000	435 psig	Bottom Block	OA17946.5
11	8350672	tube fitting	STAINLESS STEEL, ASTM A276, 316L or A479, 316	4000 psig	Bottom Block	Swagelok CRN OA12577.5C or HyLok CRN OA4093.2 or SSP CRN OA9866.5
12	8350676	tube fitting	STAINLESS STEEL, ASTM A276, 316L or A479, 316	4000 psig	Bottom Block	Swagelok CRN OA12577.5C or HyLok CRN OA4093.2 or SSP CRN OA9866.5
13	8350683	relief valve	BRASS, ASTM B-16, 36000	50 psig	Bottom Block	CG770.5R1, CH770.5R1
14	8350941	bellows	STAINLESS STEEL, ASTM A276, 316L	435 psig	Bottom Block	See test report for 577000A Attached
15	8351511	transducer	STAINLESS STEEL, 17-7	9790 psig	Bottom Block	OF17333.5; OF6726.4; CSA-OF1494.6; OF15348.2
16	8308661	elbow	BRASS, ASTM B-16, 36000	163 psig	Top Block	OA17946.5
17	8309712	elbow	BRASS, ASTM B-16 OR C37700	120 psig	Top Block	OA17946.5
18	8350655	block	BRASS, ASTM B-16, 36000	163 psig	Top Block	OA17946.5
19	8350657	cap	BRASS, ASTM B-16, 36000	500 psig	Top Block	OA17946.5
20	8350668	hose barb	BRASS, ASTM B-16, 36000	120 psig	Top Block	OA17946.5
21	8350941	bellows	STAINLESS STEEL, ASTM A276, 316L	500 psig	Top Block	OA17946.5
22	90800038	tubing	POLYURETHANE	120 psig	Top Block	OA17946.5
23	8309140-11	solenoid valve	BRASS, ASTM B-16 OR C37700	163 psig	Top Block	OA17946.5
24	8309140-18	solenoid valve	BRASS, ASTM B-16 OR C37700	163 psig	Top Block	OA17946.5
25	8309140-4	solenoid valve	BRASS, ASTM B-16 OR C37700	163 psig	Top Block	OA17946.5
26	8309150-13	switch	ZINC PLATED STEEL	163 psig	Top Block	OA17946.5

SCALE: <b>X</b>	THIRD ANGLE PROJECTION 	TOLERANCE UNLESS OTHERWISE SPEC'D DIMENSIONS ARE IN INCHES DIA. & TOL. PER ANSI Y14.5
TITLE BLOCK REVISION: #7	REVISION DATE: 1/31/2003	FINISH: XXX DECIMALS: ±.005 XX DECIMALS: ±.010 FRACTIONS: ±1/64 ANGLES: ±2° FILLET RADII: R 1/64 BREAK EDGES: .002-.010
CAD FILENAME: A.dwg	WHERE USED: ABSA File	CAGE NUMBER QA389

DRAWN BY	ITEM	PART NO / SIZE	QTY	MATERIAL / DESCRIPTION
DESIGN ENGINEERING	CONCOA		CONTROLS CORPORATION OF AMERICA PRODUCT ENGINEERING DEPARTMENT VIRGINIA BEACH, VA 23454	
MANUFACTURING ENG	ABSA Control Drawing 577		PART NO. <b>885 0040</b>	
QUALITY ASSURANCE	TITLE		ISSUING REFERENCE DOCUMENT # EP-16064	
				SIZE A

THIS DOCUMENT CONTAINS CONFIDENTIAL OR PROPRIETARY INFORMATION OF CONTROLS CORP. OF AMERICA. NEITHER THE DOCUMENT NOR THE INFORMATION THEREIN IS TO BE REPRODUCED, DISTRIBUTED, USED, OR DISCLOSED, EITHER IN WHOLE OR IN PART EXCEPT AS SPECIFICALLY AUTHORIZED, AND MUST BE RETURNED PROMPTLY WITH FINISHED MATERIAL, QUOTATION OR UPON REQUEST.

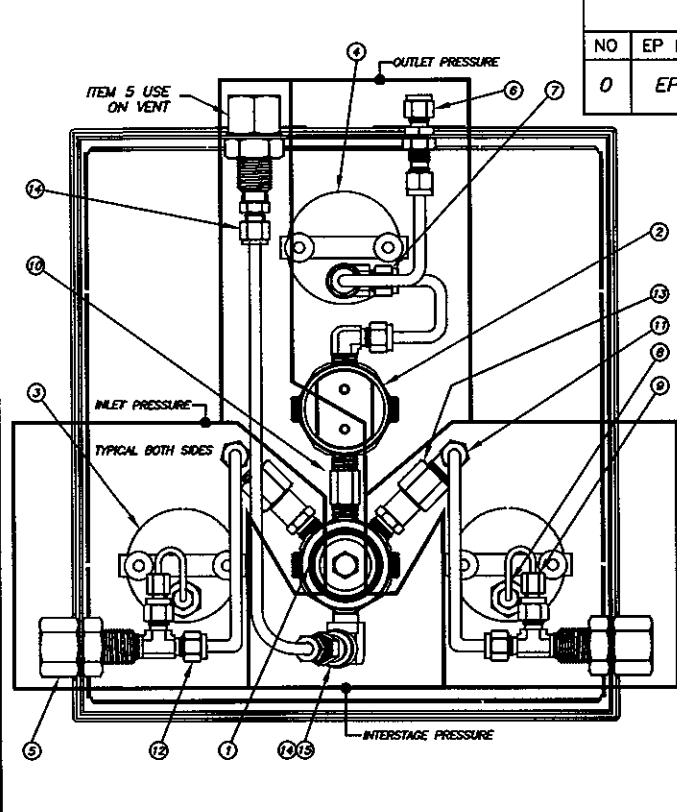

<b>Inlet Section:</b> 3000 psi @ -40°F to 140°F (3300 pneumatic leak test) Using components 1, 3, 5, 8, 9, 11, 12, 13
<b>Interstage Section:</b> 500 psi @ -40°F to 140°F (550 pneumatic leak test) Using components 1, 2, 10, 14, 15
<b>Outlet Section:</b> Option 1: 150 psi @ -40°F to 140°F (165 pneumatic leak test) Using components 2, 4c, 5, 6, 7 Option 2: 250 psi @ -40°F to 140°F (275 pneumatic leak test) Using components 2, 4b, 5, 6, 7 Option 3: 500 psi @ -40°F to 140°F (550 pneumatic leak test) Using components 2, 4a, 5, 6, 7

REVISIONS					
NO	EP NUMBER	DESCRIPTION	INITIALS	DATE	APPROVED
0	EP-16064	ISSUED FOR ABSA CRN SUBMISSION	JF	11/25/2016	_____

PT NO  
885 0041

OH 17255  
NOV 25 2016

Item Number	Part Number	Description	Material	Existing CRN Component Pressure Rating	Pressure in CONCOA Product	Existing CRN?
1	4605000 / 4625000	switch regulator	BRASS, ASTM B-16, 36000 / STAINLESS STEEL, ASTM A276, 316L	4500 psig to 500 psig	Inlet / Interstage	OH5216.SR1
2	4655000 / 4675000	delivery regulator	BRASS, ASTM B-16, 36000 / STAINLESS STEEL, ASTM A276, 316L	4500 psig to 500 psig	Interstage / Outlet	OH6216.SR1
3	8410850 / 8410851	inlet gauge	BT: ASTM B103, 52100 / ASTM A240, 31603 SOCKET: ASTM B16, 38500 / ASTM A240, 31603	4000 psig	Inlet	Winters OF8751.SC
4a	8410823 / 8410829	outlet gauge	BT: ASTM B103, 52100 / ASTM A240, 31603 SOCKET: ASTM B16, 38500 / ASTM A240, 31603	600 psig	Outlet	Winters OF8751.SC
4b	8410838 / 8410839	outlet gauge	BT: ASTM B103, 52100 / ASTM A240, 31603 SOCKET: ASTM B16, 38500 / ASTM A240, 31603	300 psig	Outlet	Winters OF8751.SC
4c	8410826 / 8410827	outlet gauge	BT: ASTM B103, 52100 / ASTM A240, 31603 SOCKET: ASTM B16, 38500 / ASTM A240, 31603	200 psig	Outlet	Winters OF8751.SC
5	8305336	inlet bulkhead	STAINLESS STEEL, ASTM A276, 316L	8000 psig	Inlet	CONCOA CRN OA17946.5
6	5558218	tube fitting	STAINLESS STEEL, ASTM A276, 316L or A183 316	6200 psig	Outlet	Swagelok CRN OA12577.5C or HyLok CRN OA4093.2 or SSP CRN OA9886.5
7	5574300	tube fitting	STAINLESS STEEL, ASTM A276, 316L or A183 316	6200 psig	Outlet	Swagelok CRN OA12577.5C or HyLok CRN OA4093.2 or SSP CRN OA9886.5
8	8305089	adapter	STAINLESS STEEL, ASTM A276, 316L or A183 316	6200 psig	Inlet	Swagelok CRN OA12577.5C or HyLok CRN OA4093.2 or SSP CRN OA9886.5
9	8307459	reducer	STAINLESS STEEL, ASTM A276, 316L or A183 316	6200 psig	Inlet	Swagelok CRN OA12577.5C or HyLok CRN OA4093.2 or SSP CRN OA9886.5
10	8306334 / 8306337	pipe nipple	BRASS, ASTM B-16, 36000 / STAINLESS STEEL, ASTM A276, 316L	7000 psig	Interstage	CONCOA CRN OA17946.5
11	5558214	tube fitting elbow	STAINLESS STEEL, ASTM A276, 316L or A183 316	6200 psig	Inlet	Swagelok CRN OA12577.5C or HyLok CRN OA4093.2 or SSP CRN OA9886.5
12	5558212	tube fitting tee	STAINLESS STEEL, ASTM A276, 316L or A183 316	6200 psig	Inlet	Swagelok CRN OA12577.5C or HyLok CRN OA4093.2 or SSP CRN OA9886.5
13	8305383 / 8305384 / 8306510	cr. brass	BRASS, ASTM B-16, 36000 / STAINLESS STEEL, ASTM A276, 316L	3000 psig	Inlet	Swagelok CRN OA12577.5C or HyLok CRN OA4093.2
14	5550220	tube fitting	STAINLESS STEEL, ASTM A276, 316L or A183 316	8000 psig	Interstage	Swagelok CRN OA12577.5C or HyLok CRN OA4093.2 or SSP CRN OA9886.5
15	8306485 / 8306198	elbow	BRASS, ASTM B-16, 36000 / STAINLESS STEEL, ASTM A276, 316L	3300 psig	Interstage	Swagelok CRN OA12577.5C or HyLok CRN OA4093.2 or SSP CRN OA9886.5

Scope includes other products utilizing identical designs for high pressure and low pressure control (to include trap ratings, pressure and all other functional aspects)

SCALE: X	THIRD ANGLE PROJECTION	TOLERANCE UNLESS OTHERWISE SPEC'D DIMENSIONS ARE IN INCHES DIM. & TOL. PER ANSI Y14.5	DRAWN BY	ITEM	PART NO / SIZE	QTY	MATERIAL / DESCRIPTION
TITLE BLOCK REVISION: #7	REVISION DATE: 1/31/2003	FINISH: $\nabla$ XXX DECIMALS: $\pm .005$ XX DECIMALS: $\pm .010$ FRACTIONS: $\pm 1/64$ ANGLES: $\pm 2^\circ$ FILLET RADII: R 1/64 BREAK EDGES: .002-.010	DESIGN ENGINEERING	<b>CONCOA</b> CONTROLS CORPORATION OF AMERICA PRODUCT ENGINEERING DEPARTMENT VIRGINIA BEACH, VA 23454			PART NO. <b>885 0041</b>
CAD FILENAME: A.dwg	WHERE USED: ABSA File	MANUFACTURING ENG	<b>ABSA Control Drawing</b> 522/523				
CAGE NUMBER: OA389			QUALITY ASSURANCE	ISSUING REFERENCE DOCUMENT #			SIZE: A
							EP-16064

November 25, 2016

**Attention:** Tanya Francis  
TECHNICAL STANDARDS & SAFETY AUTHORITY  
345 CARLINGVIEW DRIVE  
TORONTO, ON M9W 6N9

**Email:** tfrancis@tssa.org

The design submission, tracking number 2016-02810, originally received on May 13, 2016 was surveyed and accepted for registration as follows:

**CRN :** 0H17255.2 **Accepted on:** November 25, 2016

**Reg Type:** New Design **Expiry Date:** November 25, 2026

**Drawing No. :** 885 0038, ETC. Rev 0 As Noted

**Fitting type:** REGULATOR ASSEMBLIES

Design registered in the name of : CONTROLS CORPORATION OF AMERICA

**The registration is conditional on your compliance with the following notes:**

- This registration also includes drawings 885 0039 Rev 0, 885 0040 Rev 0, and 885 0041 Rev 0.
- The indication of CRN 0H05215.52 on drawing 885 0038 is understood to be a typographical error, intended to indicate CRN 0H05216.52.
- Parts used shall be those listed on the Bill of Materials of each drawing and are understood to be registered under the listed CRN, which is understood to be valid in Alberta and unexpired, and suited to the design service conditions. It is not permissible to substitute equivalent parts not manufactured within the scope of the listed CRNs. I have struck out the corresponding note on each drawing permitting identical part substitutions.
- This equipment shall not be pneumatically tested in Alberta.

As indicated on AB-41 Statutory Declaration form and submitted documentation, the code of construction is ASME B31.3.

*This registration is valid only for fittings fabricated at the location(s) covered by the QC certificate attached to the accepted AB-41 Statutory Declaration form. This registration is valid only until the indicated expiry date and only if the Manufacturer maintains a valid quality management system approved by an acceptable third-party agency until that date. Should the approval of the quality management system lapse before the expiry date indicated above, this registration shall become void.*

An invoice covering survey and registration fees will be forwarded from our Revenue Accounts.

If you have any question don't hesitate to contact me by phone at (780) 433-0281 ext 3386 or fax (780) 437-7787 or e-mail brandon@absa.ca.

Sincerely,



BRANDON, GREG